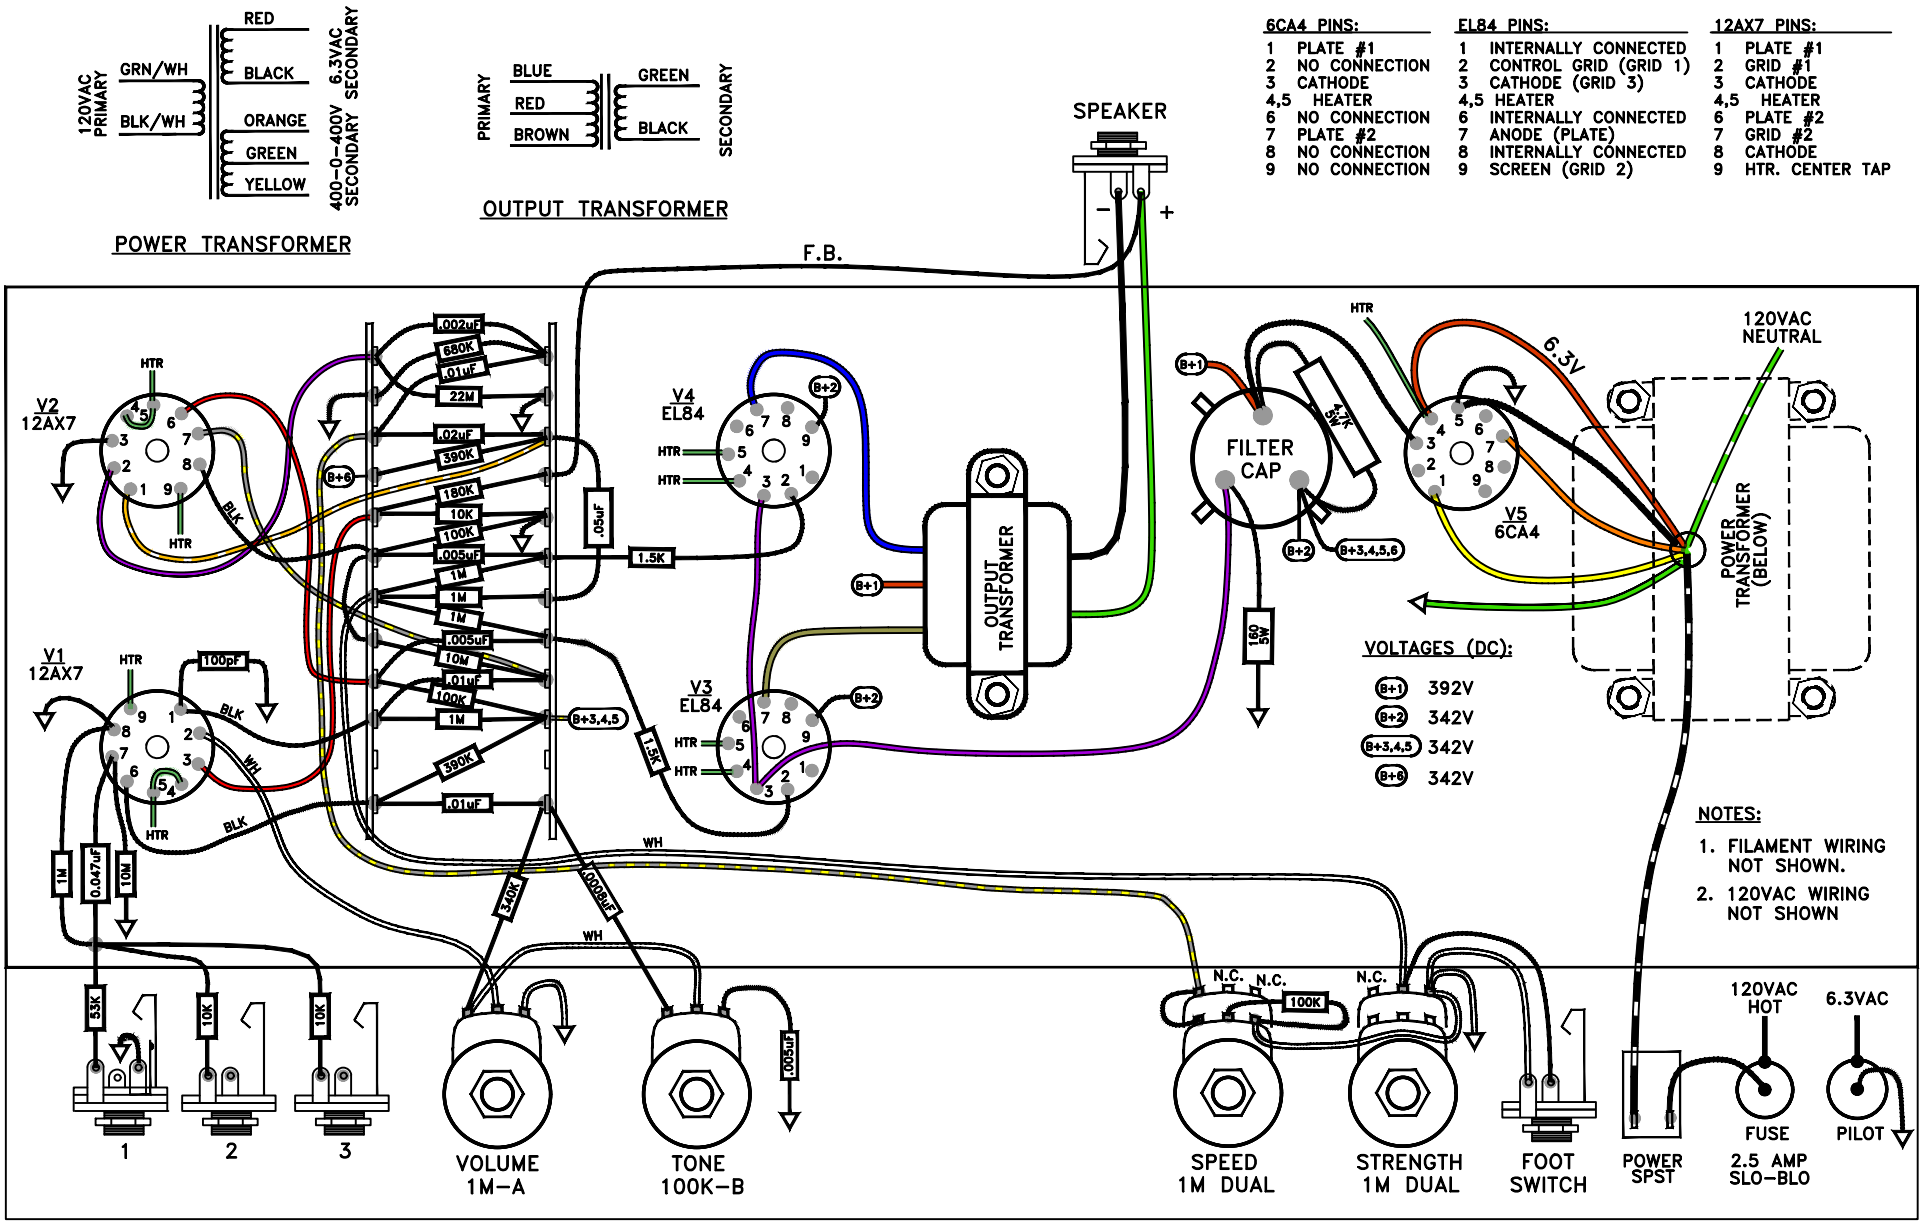

Gregory MARK X
As-Built Chassis Layout
Paul Marossy 5/22/05